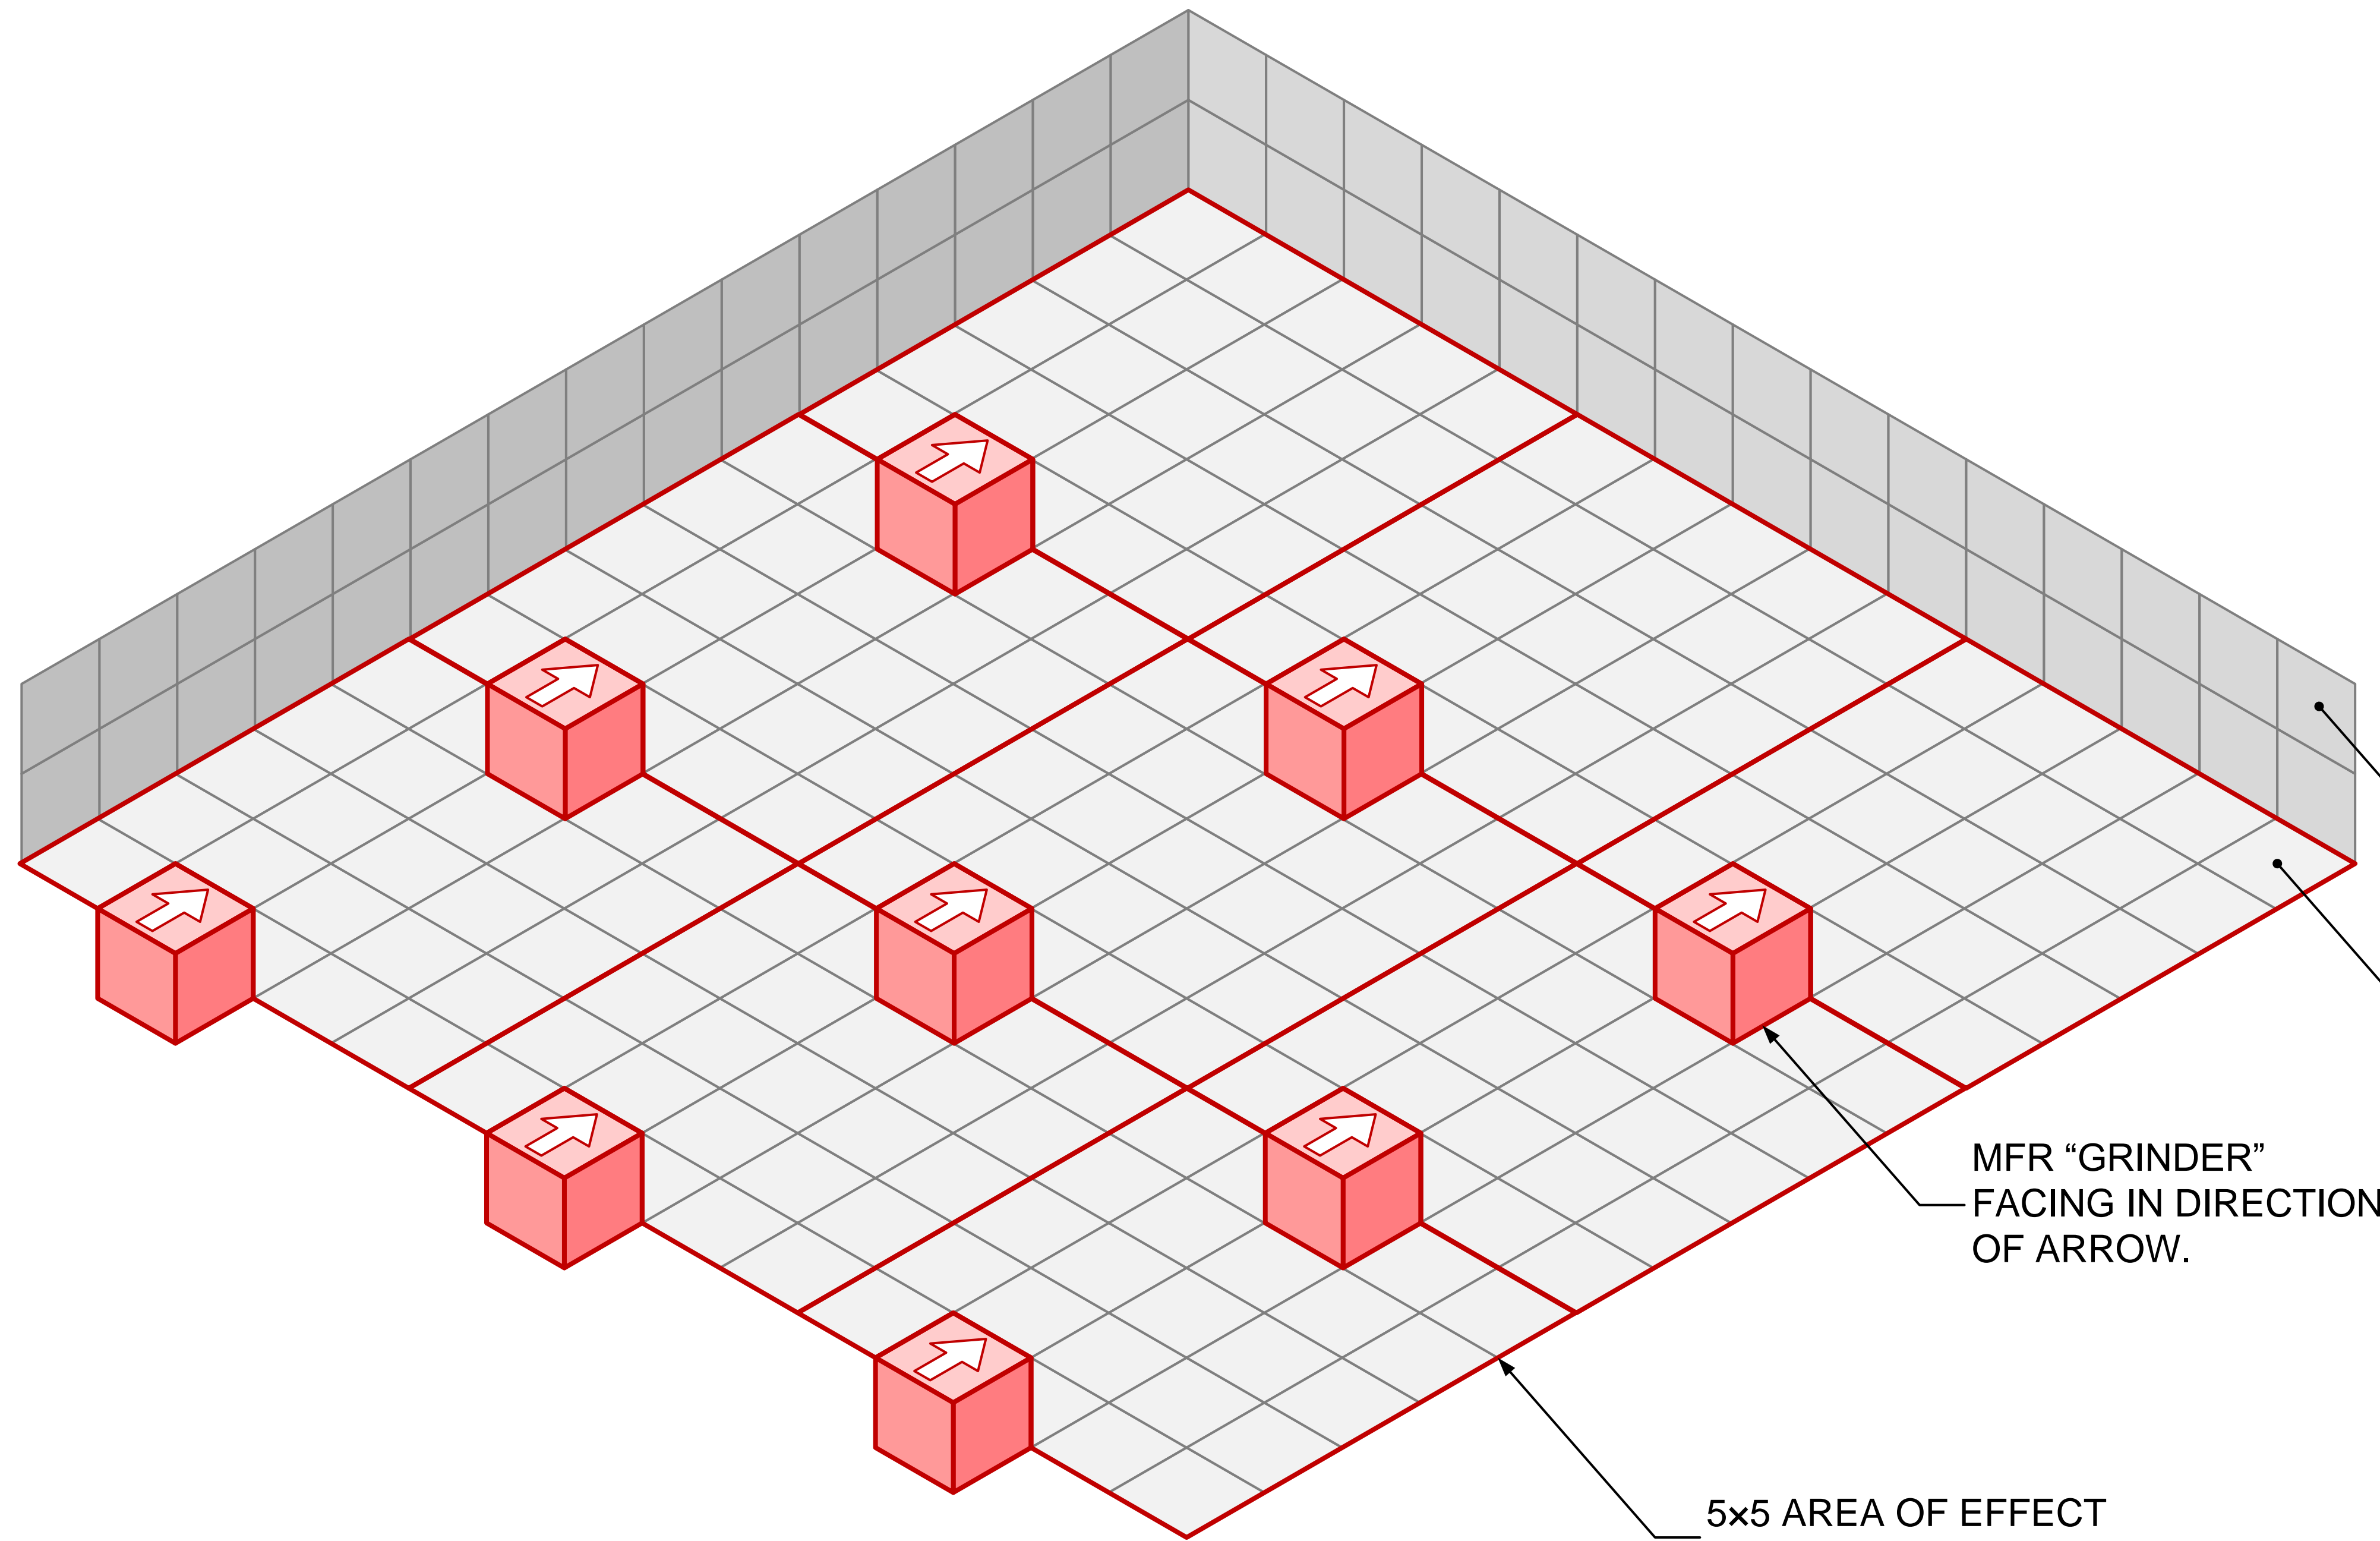


CONSTRUCTION NOTES:

1. CONCEAL ALL CONDUIT WORK BELOW FLOOR.



WALLS TO BE BLAST RESISTANT MATERIAL

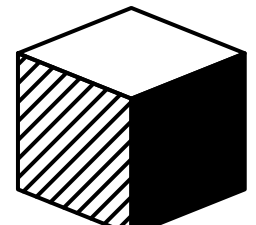

FLOOR IS MADE FROM EXTRA UTILITIES "CURSED EARTH".

MFR "GRINDER" FACING IN DIRECTION OF ARROW.

5x5 AREA OF EFFECT OF ONE MFR GRINDER

ISOMETRIC VIEW
NOT TO SCALE

AS BUILT

						NOT TO SCALE		1 OF 1		 LWS INDUSTRIES 42 WALLABY WAY PERTH WA 6000 AUSTRALIA +618 5550 1234 minecraft@perwatch.net		MINECRAFT - BEVO'S TECH PACK					
						SCALE - ALL DIMENSIONS IN MM U.N.O.		SHEET				MOB GRINDER					
						 ORIGINAL DRAWING SIZE A1 - 100 MILLIMETRE PAPER SCALE				CURSED EARTH SPAWNING ROOM							
B	AS BUILT					L.A.YIP	-	-	2014-10-11	DRAWING TITLE XYZZY		271828-314.15				B	
A	ISSUED FOR CONSTRUCTION					L.A.YIP	-	-	2014-10-10	PROJECT NUMBER XYZZY		DRAWING NUMBER				REVISION	
REV.	ISSUE					DRAWN	CHECKED	APPROVED	DATE	FILE NAME Mob Grinder General Arrangement.vsd							